


DOOR SCHEDULE					
S.NO.	TYPE	SIZE	CLL LEVEL	LINTEL LEVEL	
1	D1	1200 X 2100	00	2100	
2	D2	1200 X 2100	00	2100	
3	D3	900 X 2100	00	2100	
4	D4	750 X 2100	00	2100	
5	D4'	750 X 2400	00	2400	
6	DW1	2400 X 2400 / 2100	00/300	2400	
7	DW2	1800 X 2400 / 2100	00/300	2400	
8	DW3	1600 X 2400 / 2100	00/300	2400	
9	DW4	1500 X 2400 / 1350	00/1050	2400	
10	DW5	1300 X 2400 / 2100	00/300	2400	
11	FD	1200 X 2100	00	2100	

WINDOW SCHEDULE					
S.NO.	TYPE	SIZE	CLL LEVEL	LINTEL LEVEL	
1	W1	1800 X 2100	300	2400	
2	W2	2400 X 2100	300	2400	
3	W2'	2400 X 2100	300	2400	
4	W3	1200 X 2100	300	2400	
5	W4	1000 X 1350	1050	2400	
6	W5	700 X 2100	300	2400	
7	W6	480 X 2100	300	2400	
8	W7	1300 X 2100	300	2400	
9	V	600 X 1200	1200	2400	

ACCESS DOOR			
S.NO.	TYPE	CLL LEVEL	LINTEL LEVEL
1	AD1	900 X 1800	300 2100
2	AD2	900 X 1800	300 2100



TOWER A - PAINT HOUSE 18TH. FLOOR F.A.R./COVERED AREA CALCULATIONS					
TOTAL AREA	LENGTH	WIDTH	AREA	NO.	TOTAL
01	6.09	2.515	0	15.316	2 30.633 SQMT.
02	9.575	3.945	0	37.773	2 75.547 SQMT.
03	0.6	1.73	0	1.038	2 2.076 SQMT.
04	1.915	2.86	0	5.477	2 10.954 SQMT.
05	2.09	3.53	0	7.378	2 14.755 SQMT.
06	6.535	10.66	0	69.663	2 139.326 SQMT.
07	2.515	2.11	0	5.307	2 10.613 SQMT.
08	1.99	2.68	0	5.333	2 10.666 SQMT.
09	2.51	4.795	0	12.035	2 24.071 SQMT.
10	3.785	2.14	0	8.057	2 16.114 SQMT.
11	7.3	3.42	0	24.966	2 49.932 SQMT.
12	2.445	1.765	0	4.315	2 8.631 SQMT.
13	8.075	5.185	0	41.869	2 83.738 SQMT.
14	1.09	5.075	0	5.532	2 11.064 SQMT.
15	4.015	3.59	0	12.808	2 25.615 SQMT.
16	2.36	2.515	0	5.935	2 11.871 SQMT.
17	3.83	1.69	0	6.473	2 12.945 SQMT.
18	2.71	4.635	0	12.561	2 25.121 SQMT.
19	2.485	5.335	0	13.257	2 26.513 SQMT.
20	8.52	7.575	0	64.539	2 129.078 SQMT.
21	2.105	5.34	0	11.241	2 22.482 SQMT.
22	2.71	4.64	0	12.574	2 25.147 SQMT.
<b>TOTAL (A)</b>					<b>652.724 SQMT.</b>

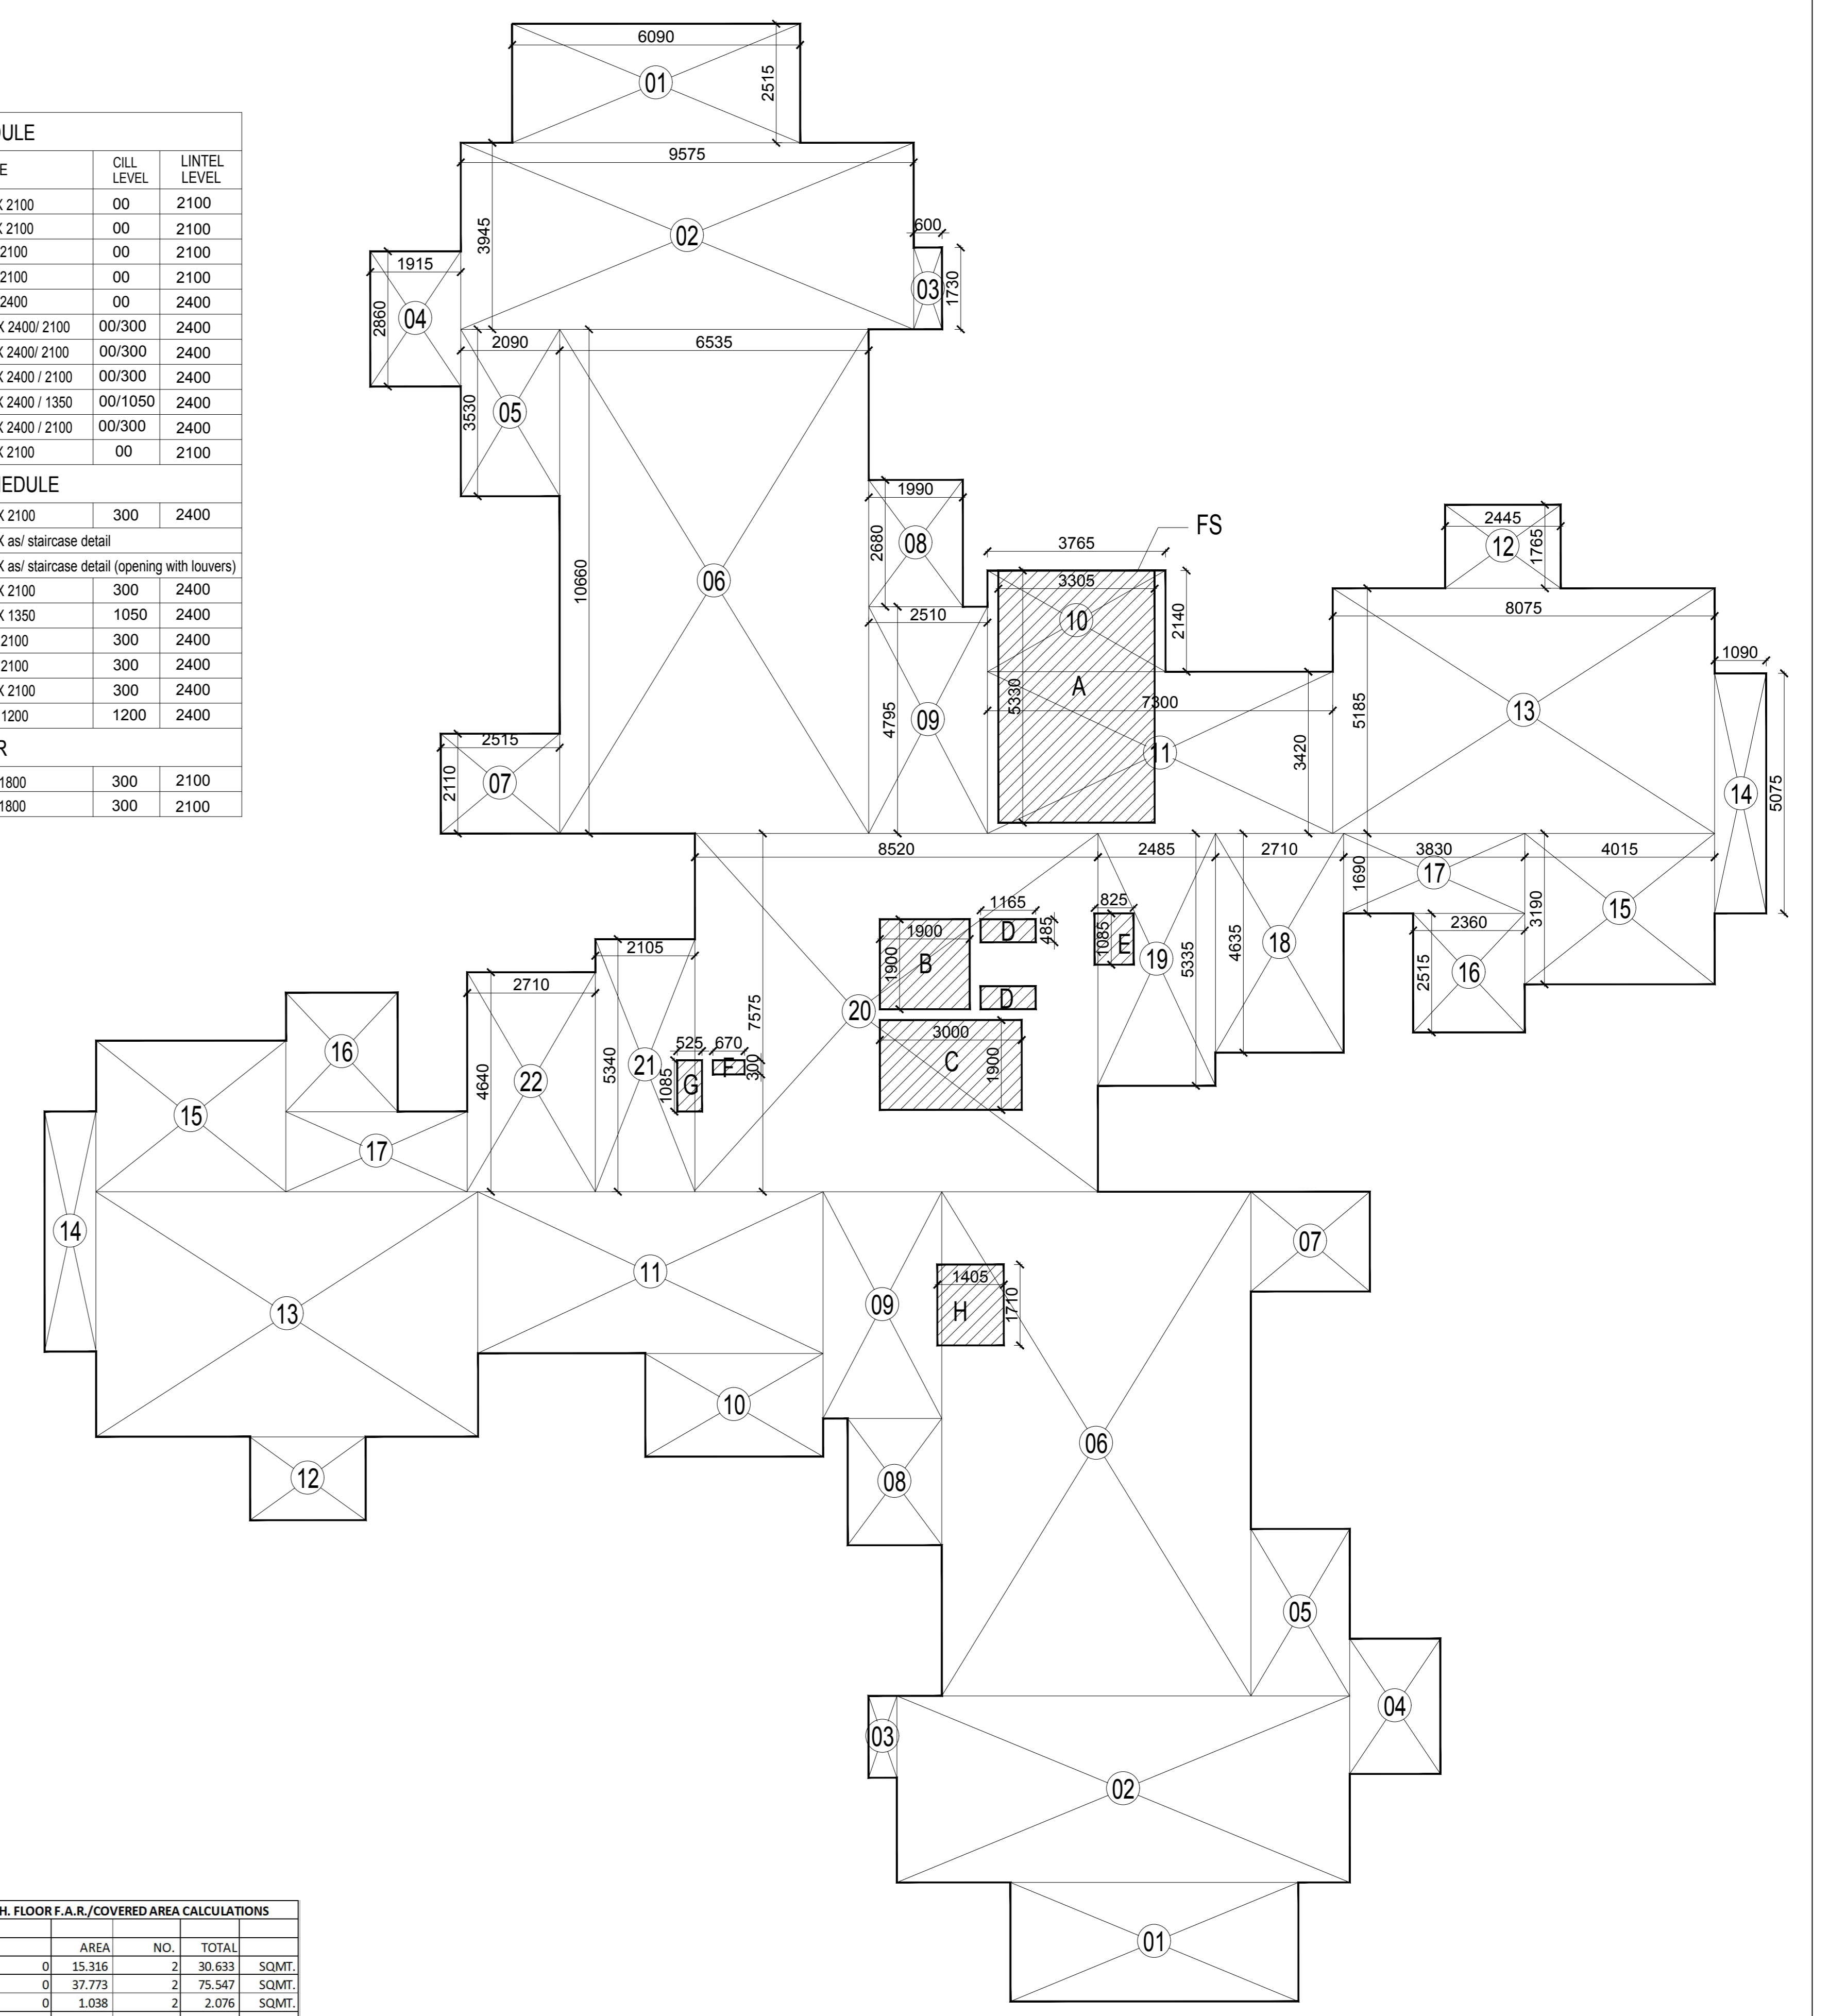LIFT WELL					
LENGTH	WIDTH	AREA	NO.	TOTAL	
B	1.9	1.9	0	3.610	1 3.610 SQMT.
C	1.9	3	0	5.700	1 5.700 SQMT.
<b>TOTAL (B)</b>					<b>9.310 SQMT.</b>

FIRE STAIRCASE (free of far)					
LENGTH	WIDTH	AREA	NO.	TOTAL	
A	5.33	3.305	0	17.616	1 17.616 SQMT.
<b>TOTAL (C)</b>					<b>17.616 SQMT.</b>


  

CUT-OUT					
LENGTH	WIDTH	AREA	NO.	TOTAL	
D	1.155	0.465	0	0.536	2 1.072 SQMT.
E	1.085	0.825	0	0.895	2 1.790 SQMT.
F	0.67	0.3	0	0.201	1 0.201 SQMT.
G	0.525	1.085	0	0.570	1 0.570 SQMT.
H	1.405	1.73	0	2.430	1 2.430 SQMT.
<b>TOTAL (D)</b>					<b>5.198 SQMT.</b>

<b>TOTAL FAR AREA = A+(B+C+D) =</b>	<b>620.600 SQMT.</b>
-------------------------------------	----------------------

18TH. FLOOR LOWER PENTHOUSE

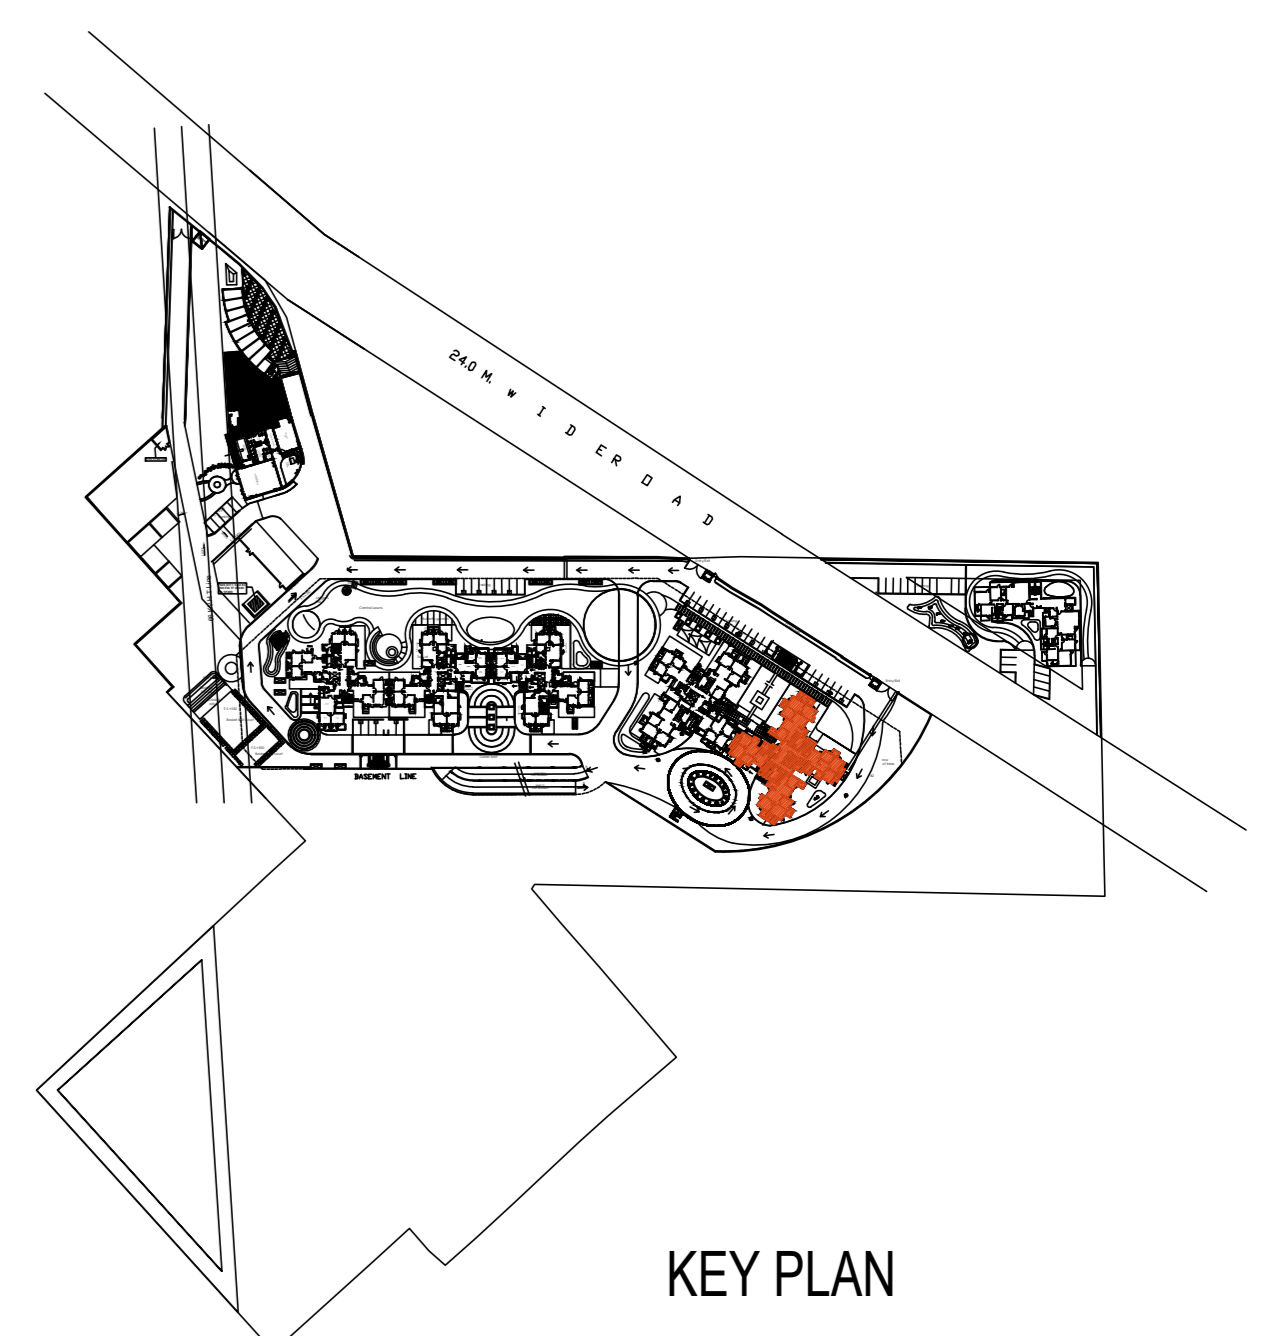

KEY PLAN

PROJECT:-  
**AS BUILT DRAWING**  
 OF GROUP HOUSING AT PLOT NO.-  
 THE ESFERA' AT SECTOR-37 C, GURGAON  
 FOR -----

ARCHITECT'S SIGNATURE

CLIENT'S SIGNATURE

SCALE : 1:100

DATE : ---

TOWER (A)  
 PENTHOUSE LOWER FLOOR  
 18TH. FLOOR PLAN

**dfA**  
 DESIGN FORUM  
 OF ARCHITECTS  
 www.dfa.in  
 C-10, SECTOR - 3, NOIDA - 201301  
 (NCR DELHI) INDIA  
 TEL : +91 120 460 1000  
 FAX : +91 120 460 1000  
 dfaconsultants@gmail.com

DRG. NO.  
**103**

REV.