
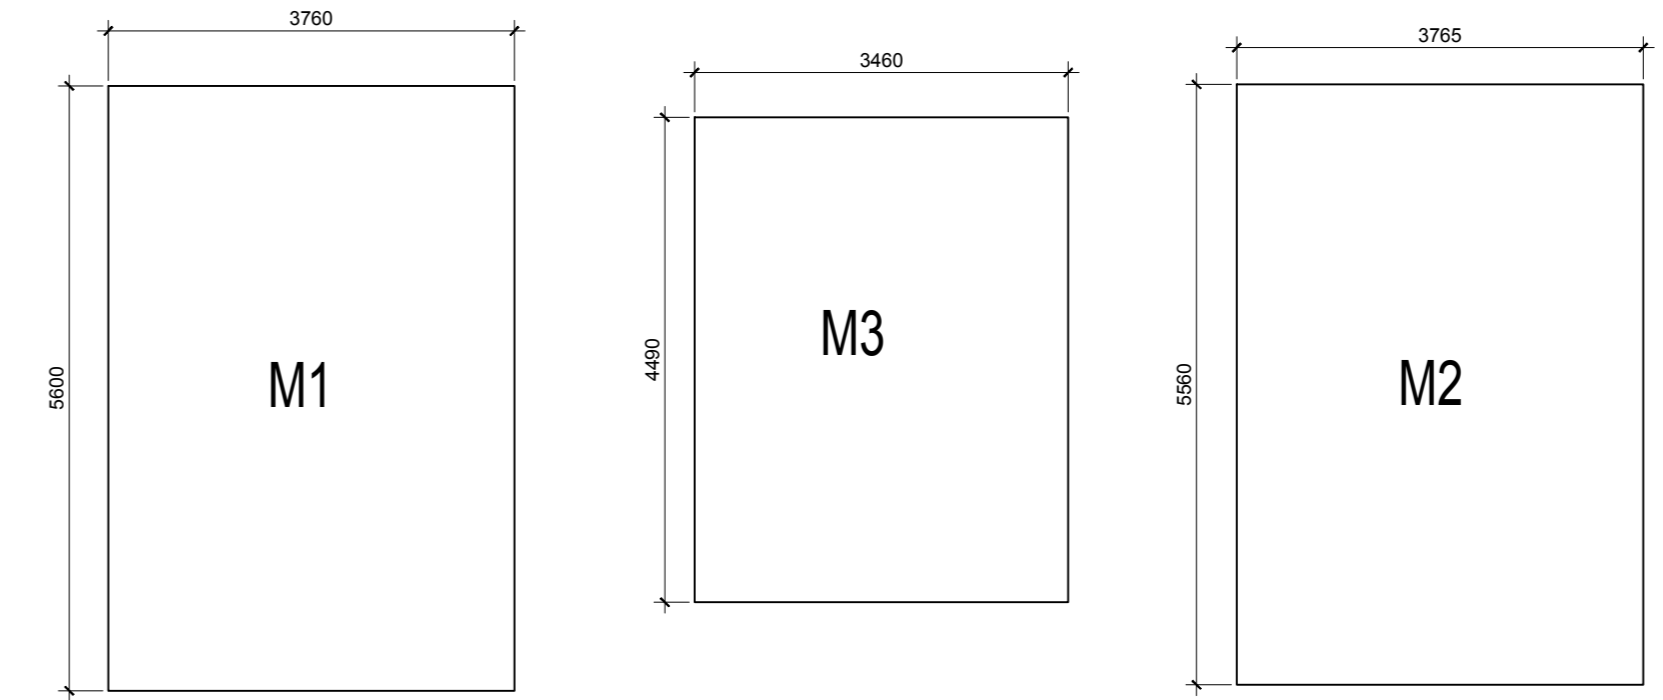



DOOR SCHEDULE				
S.NO.	TYPE	SIZE	CILL/LEVEL	UNTEL LEVEL
1	D1	1200 X 2100	00	2100
2	FD	1200 X 2100	00	2100

WINDOW SCHEDULE				
S.NO.	TYPE	SIZE	CILL/LEVEL	UNTEL LEVEL
1	W2	2400 X AS/STAIR CASE DETAIL		

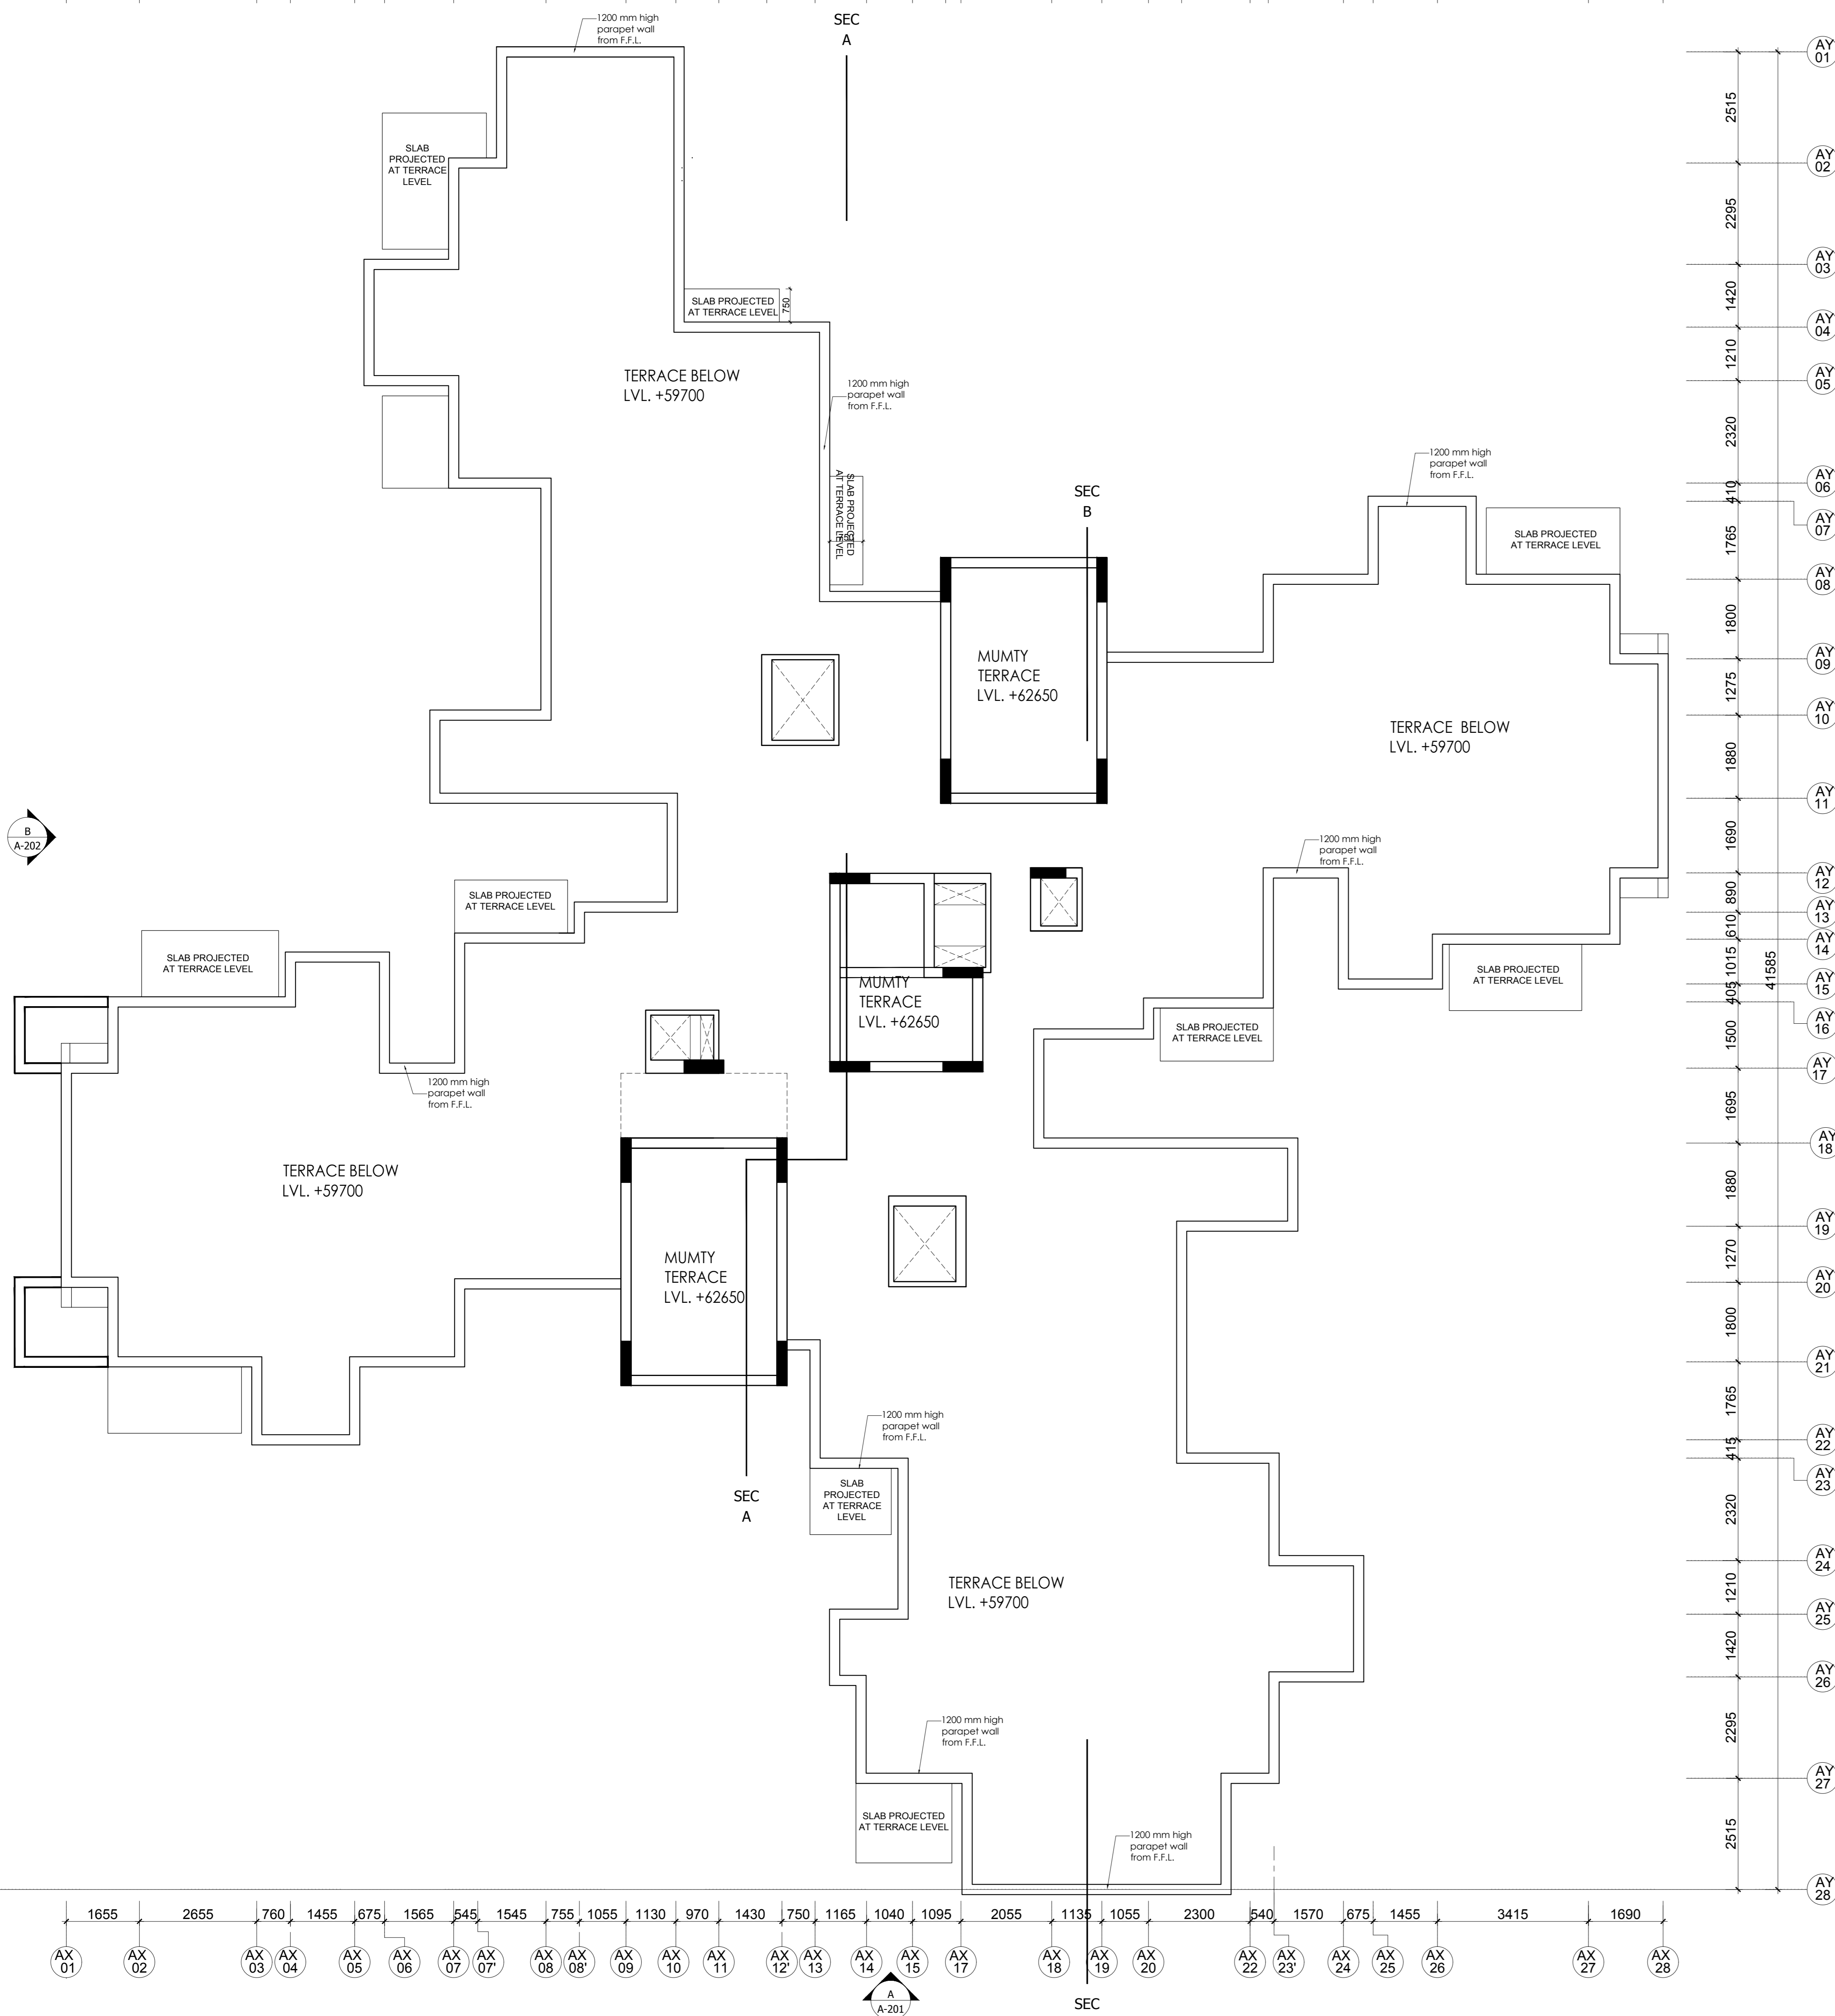

MUMTY AND MACH.ROOM AREA DIAGRAM

TOWER A - MUMTY AND MACH.ROOM					
TOTAL AREA	LENGTH	WIDTH	AREA	NO.	TOTAL
M1	3.76	5.6	21.056	1	21.056 SQMT.
M2	3.46	4.49	15.535	1	15.535 SQMT.
M3	3.765	5.56	20.933	1	20.933 SQMT.
TOTAL (A)					57.525 SQMT.

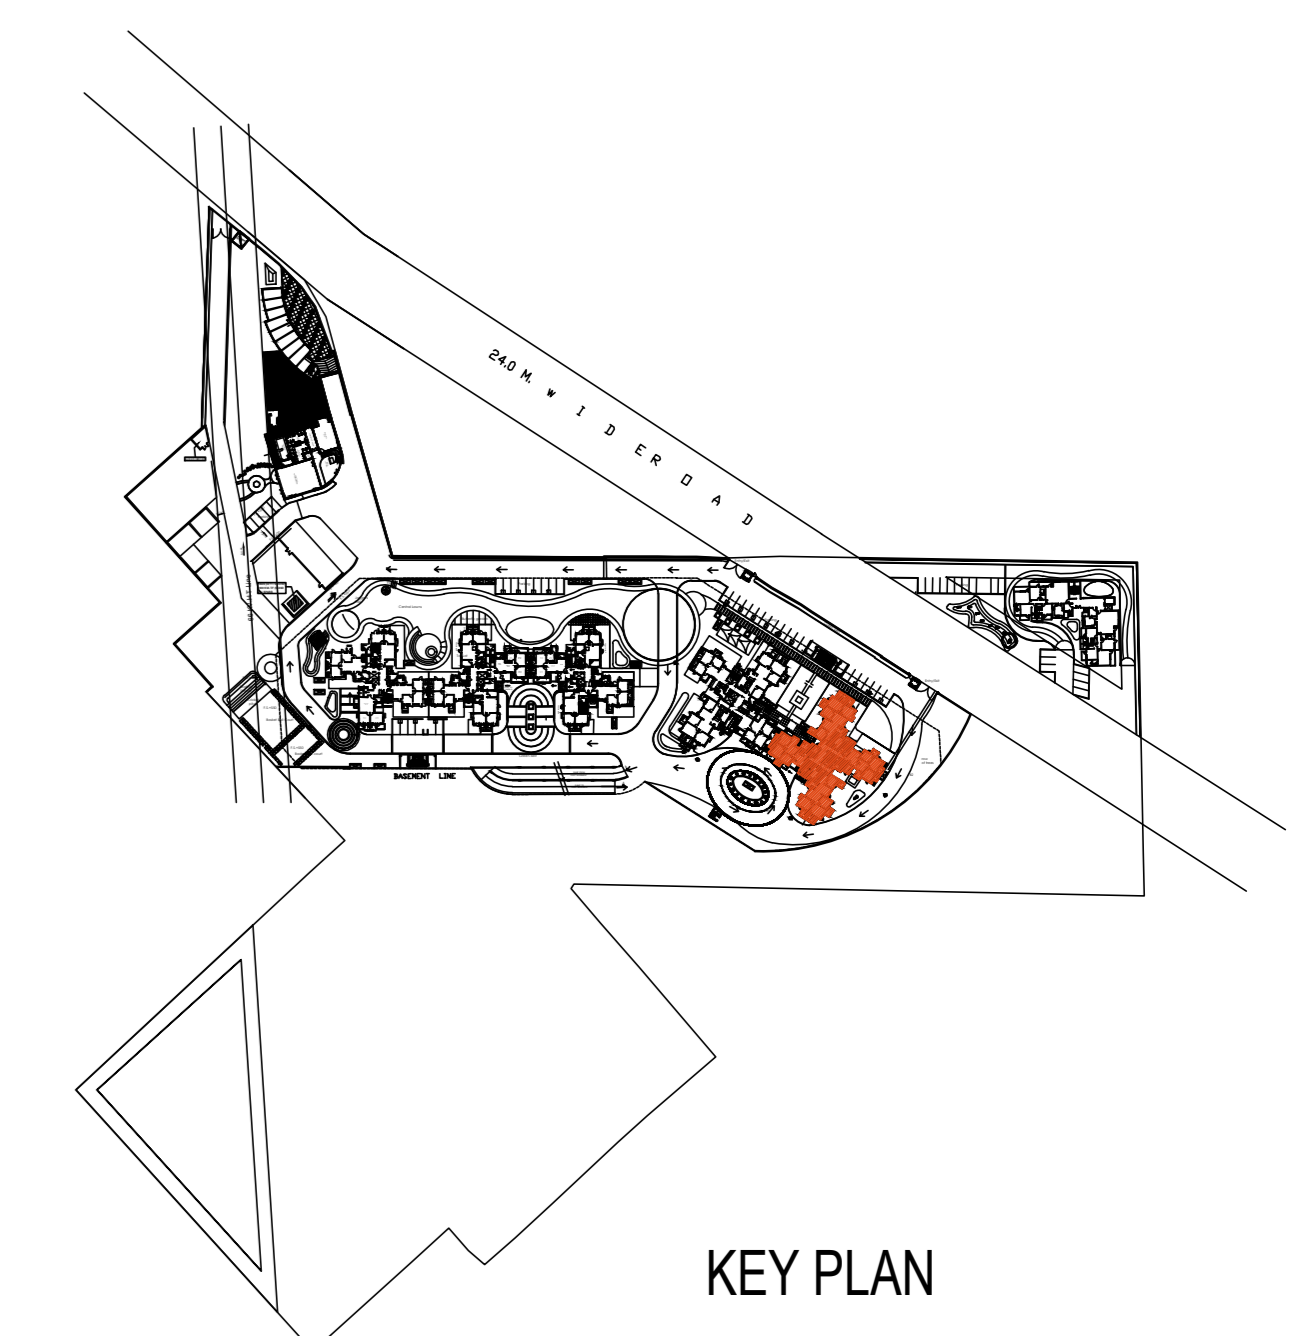

KEY PLAN

PROJECT:- AS BUILT DRAWING OF GROUP HOUSING AT PLOT NO.- THE ESFERA' AT SECTOR-37 C, GURGAON FOR -----	ARCHITECT'S SIGNATURE CLIENT'S SIGNATURE	SCALE : 1:100 DATE : ---	TOWER (A) TERRACE PLAN	 DESIGN FORUM OF ARCHITECTS www.dfa.in C - 10, SECTOR - 3, NOIDA - 201301 (NCR DELHI) INDIA TEL : +91 120 460 1000 FAX : +91 120 460 1000 dfaconsultants@gmail.com	DRG. NO. 105 REV.
--	---	---------------------------------	-----------------------------------	--	------------------------------------