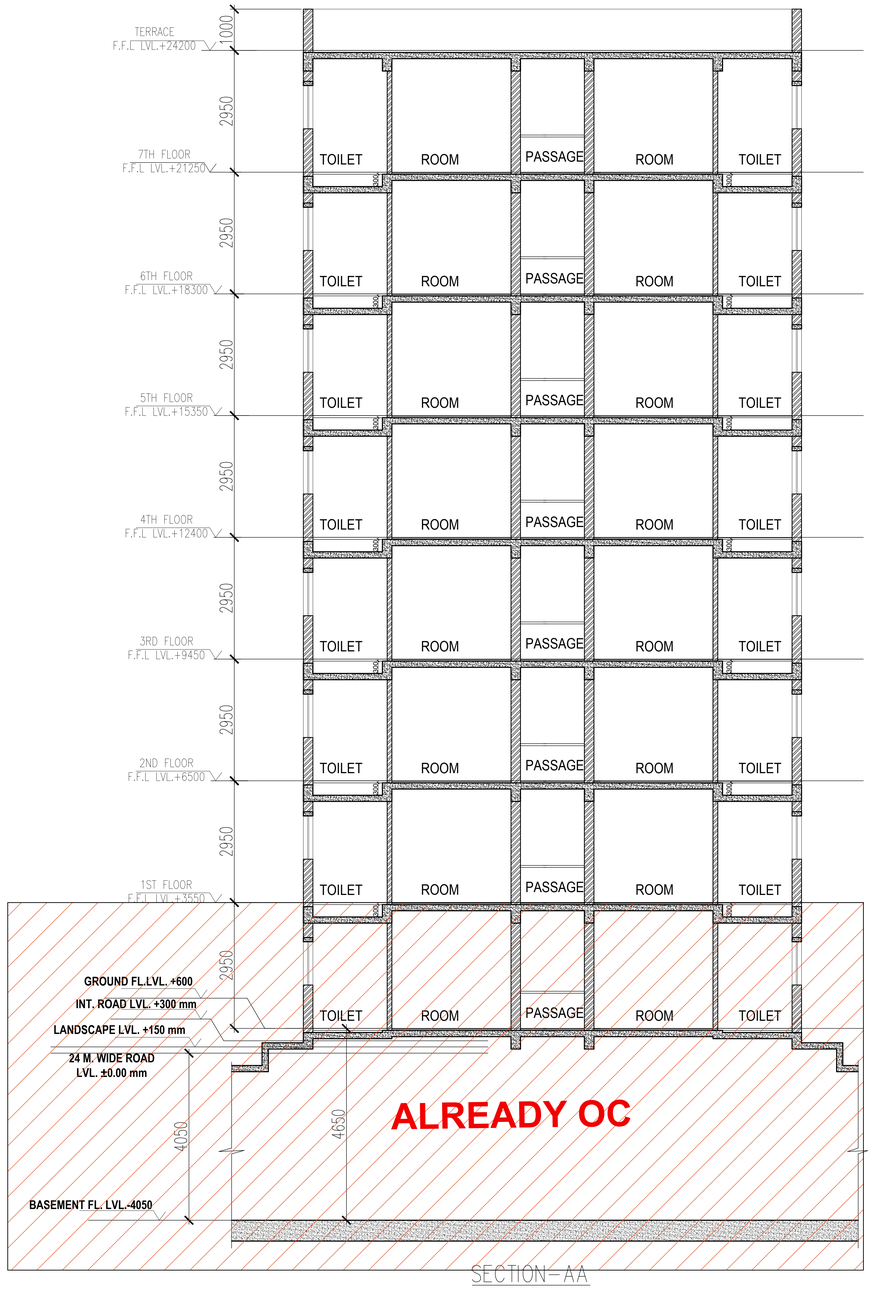

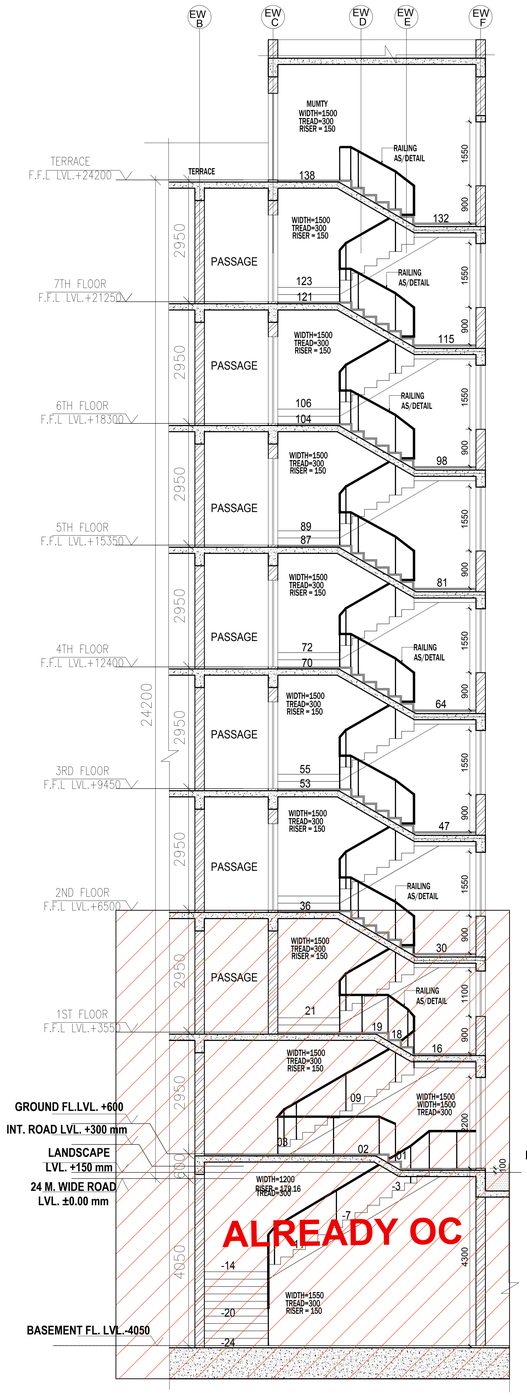

SECTION AA

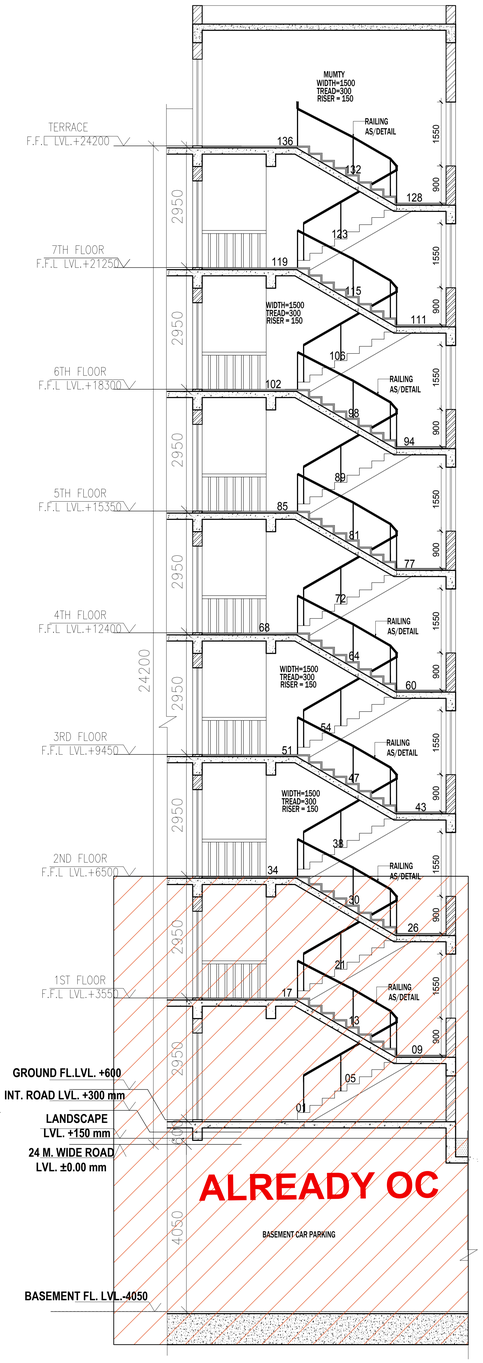

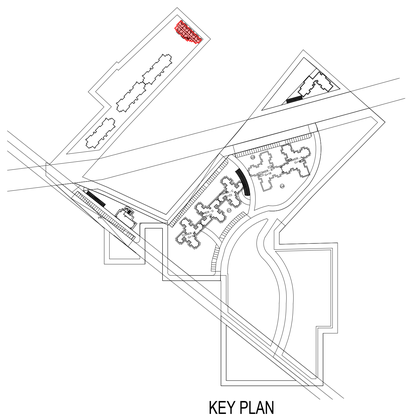

KEY PLAN

PROJECT:-	ARCHITECT'S SIGNATURE	CLIENT'S SIGNATURE				DRG. NO.
AS BUILT DRAWING OF GROUP HOUSING AT PLOT NO.- THE ESFERA' AT SECTOR-37 C, GURGAON FOR ----------			SCALE : 1:100 DATE : ----	EWS SECTION	DESIGN FORUM OF ARCHITECTS www.dfa.in C-10, SECTOR-3, NOIDA-201301 (NCR DELHI) INDIA TEL: +91 120 460 1000 FAX: +91 120 460 1000 dfaconsultants@gmail.com	102 REV. N